FORSYTH CO,NC FEE:$ 21.00
PRESENTED & RECORDED: 03/01/2004 10:11AM
DICKIE C. WOOD REGISTER OF DEEDS BY:NAVARR
BK 1 P 714 - P 714

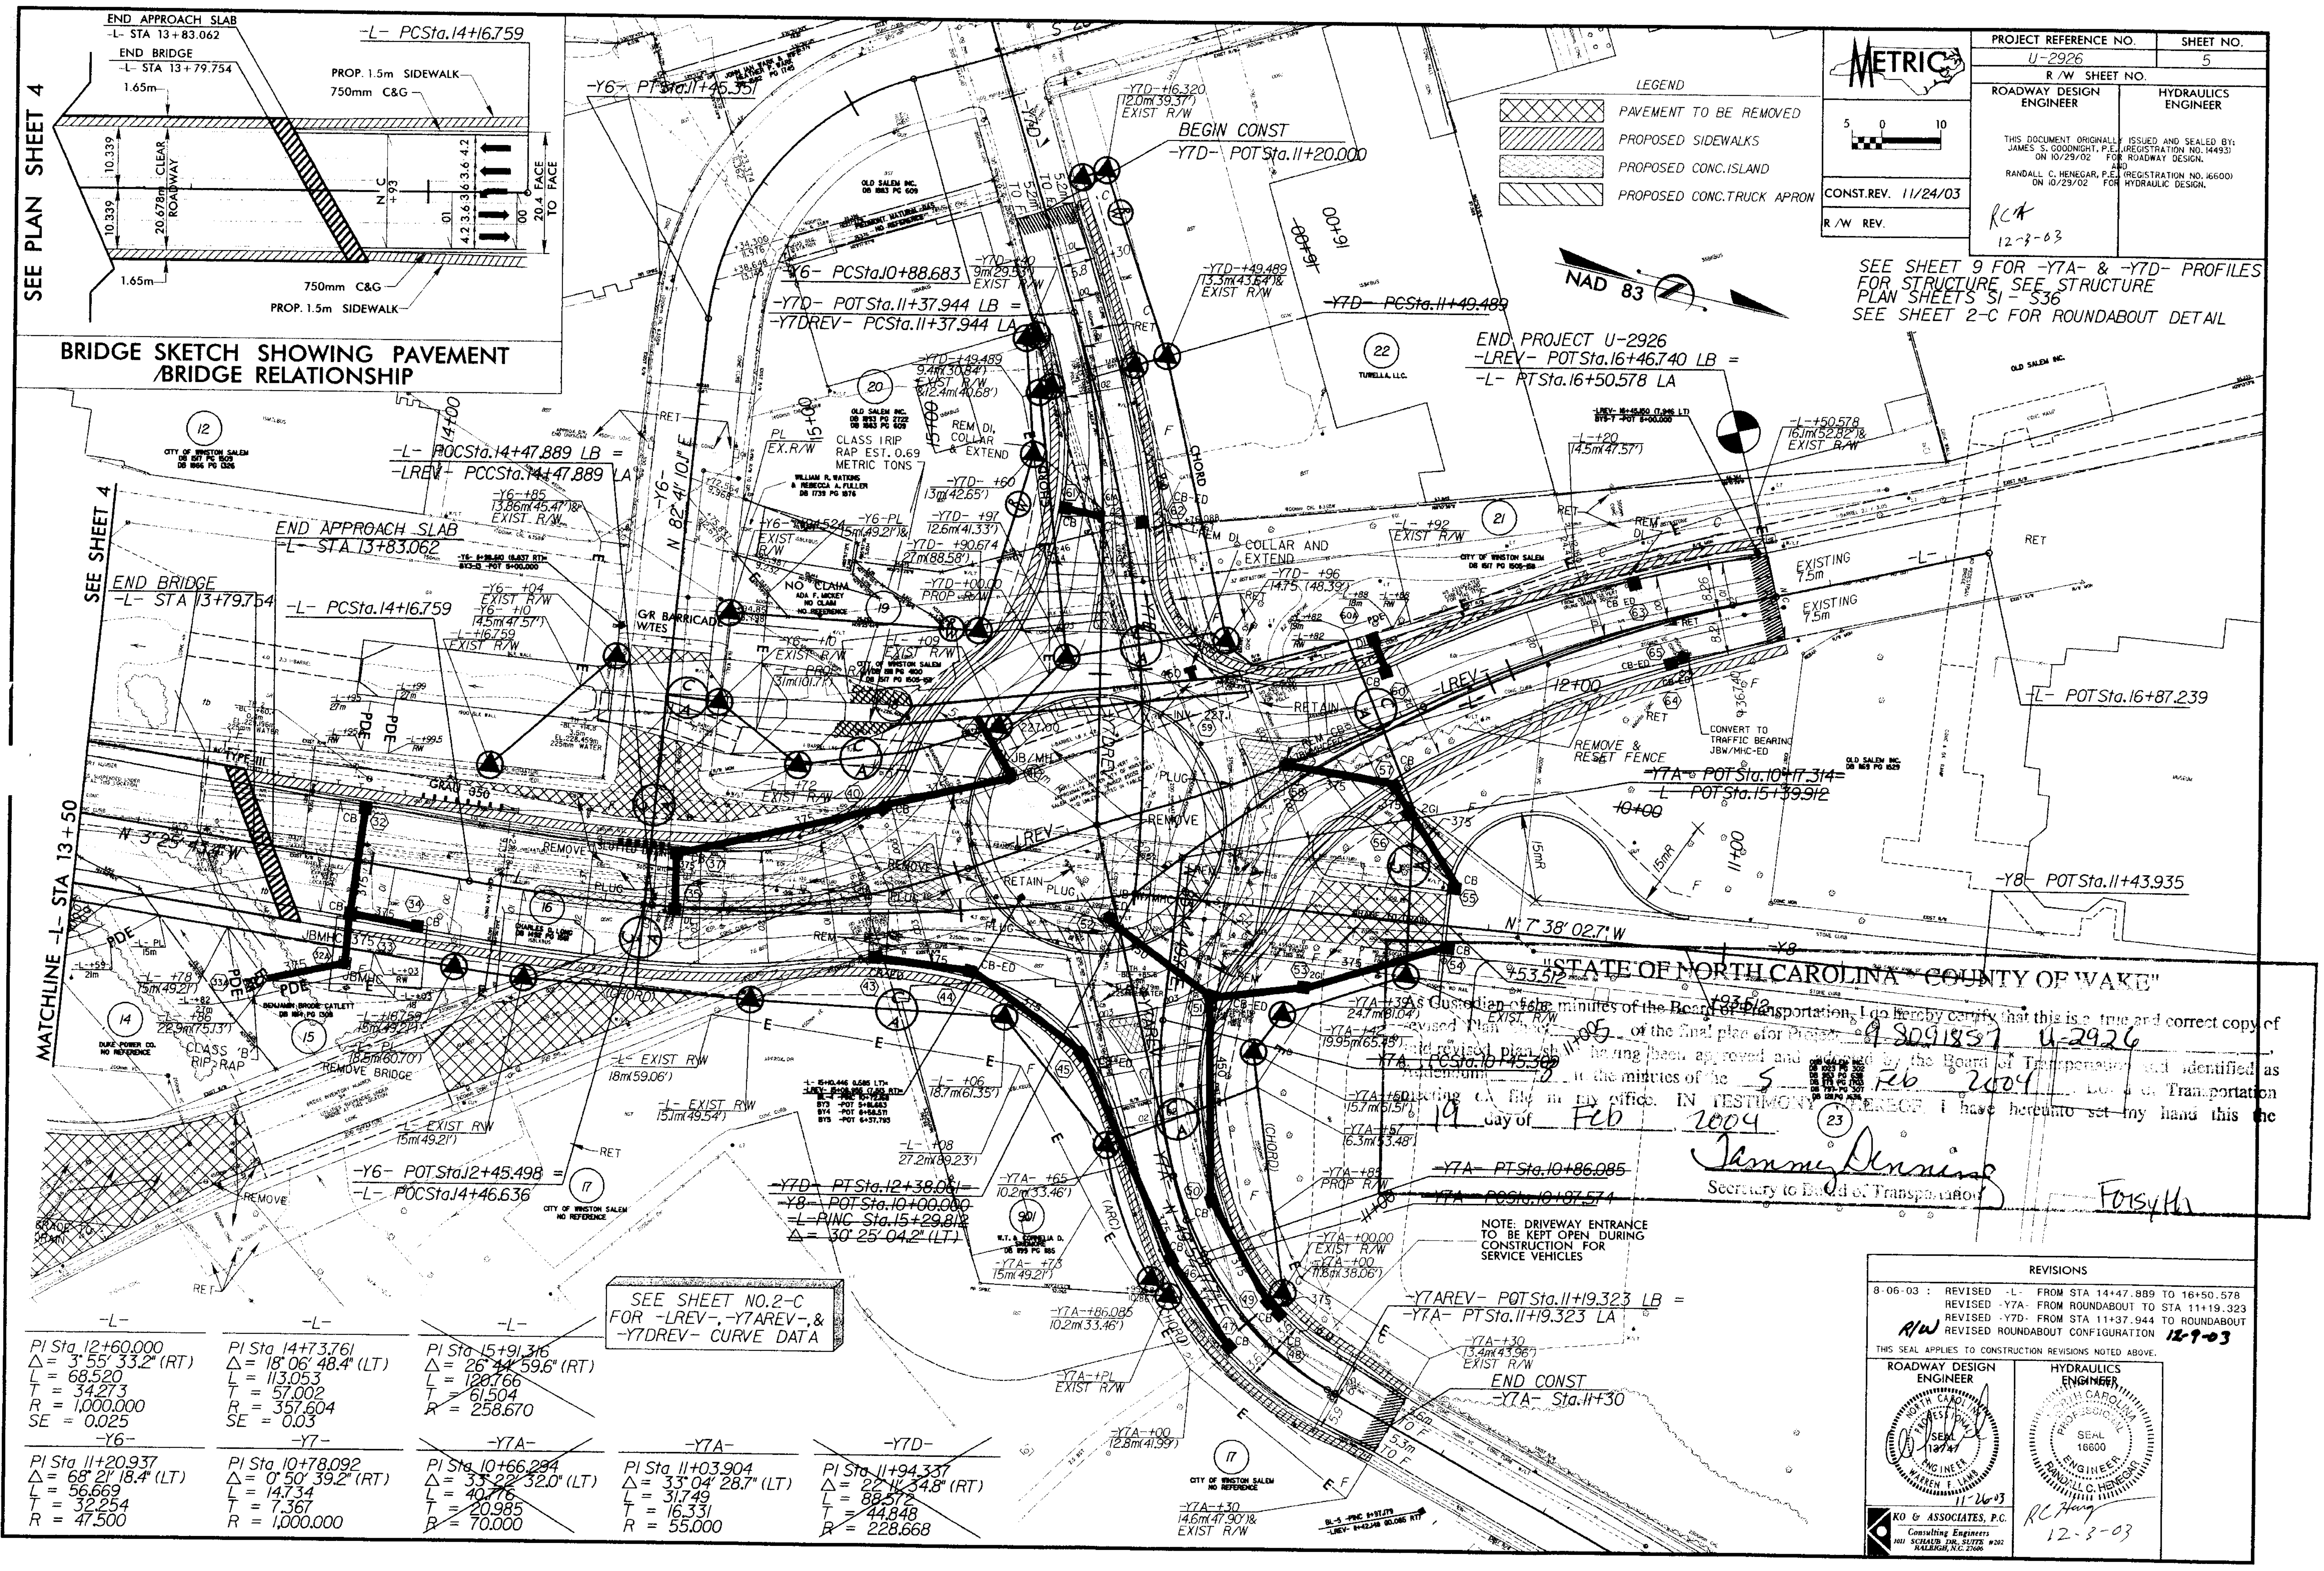

BRIDGE SKETCH SHOWING PAVEMENT /BRIDGE RELATIONSHIP

LEGEND

- ▨ PAVEMENT TO BE REMOVED
- ▨ PROPOSED SIDEWALKS
- ▨ PROPOSED CONC.ISLAND
- ▨ PROPOSED CONC.TRUCK APRON

NOTE: DRIVEWAY ENTRANCE TO BE KEPT OPEN DURING CONSTRUCTION FOR SERVICE VEHICLES

SEE SHEET NO.2-C FOR -LREV-, -Y7AREV-, & -Y7DREV- CURVE DATA

-L-
PI Sta 12+60.000
Δ = 3° 55' 33.2" (RT)
L = 68.520
T = 34.273
R = 1,000.000
SE = 0.025

-L-
PI Sta 14+73.761
Δ = 18° 06' 48.4" (LT)
L = 113.053
T = 57.002
R = 357.604
SE = 0.03

-L-
~~PI Sta 15+91.316~~
~~Δ = 26° 44' 59.6" (RT)~~
~~L = 120.766~~
~~T = 61.504~~
~~R = 258.670~~

-Y6-
PI Sta 11+20.937
Δ = 68° 21' 18.4" (LT)
L = 56.669
T = 32.254
R = 47.500

-Y7-
PI Sta 10+78.092
Δ = 0° 50' 39.2" (RT)
L = 14.734
T = 7.367
R = 1,000.000

-Y7A-
~~PI Sta 10+66.294~~
~~Δ = 33° 22' 32.0" (LT)~~
~~L = 40.776~~
~~T = 20.985~~
~~R = 70.000~~

-Y7A-
PI Sta 11+03.904
Δ = 33° 04' 28.7" (LT)
L = 31.749
T = 16.331
R = 55.000

-Y7D-
~~PI Sta 11+94.337~~
~~Δ = 22° 11' 34.8" (RT)~~
~~L = 88.572~~
~~T = 44.848~~
~~R = 228.668~~

"STATE OF NORTH CAROLINA - COUNTY OF WAKE"

As Custodian of the minutes of the Board of Transportation, I do hereby certify that this is a true and correct copy of revised Plan Sheet 5 of the final plan for Project 9.8091857 U-2926, said revised plan sheet having been approved and adopted by the Board of Transportation and identified as Addendum 2 to the minutes of the 5 Feb 2004 Board of Transportation meeting on file in my office. IN TESTIMONY WHEREOF I have hereunto set my hand this the 19 day of Feb, 2004.

Tammy Denning
Secretary to Board of Transportation

Forsyth

PROJECT REFERENCE NO.	SHEET NO.
U-2926	5
R/W SHEET NO.	

METRIC

5 0 10

CONST.REV. 11/24/03

R/W REV.

ROADWAY DESIGN ENGINEER

HYDRAULICS ENGINEER

THIS DOCUMENT ORIGINALLY ISSUED AND SEALED BY:
JAMES S. GOODNIGHT, P.E.,(REGISTRATION NO. 14493)
ON 10/29/02 FOR ROADWAY DESIGN.
AND
RANDALL C. HENEGAR, P.E., (REGISTRATION NO. 16600)
ON 10/29/02 FOR HYDRAULIC DESIGN.

RCH
12-3-03

SEE SHEET 9 FOR -Y7A- & -Y7D- PROFILES
FOR STRUCTURE SEE STRUCTURE
PLAN SHEETS S1 - S36
SEE SHEET 2-C FOR ROUNDABOUT DETAIL

REVISIONS

8-06-03 : REVISED -L- FROM STA 14+47.889 TO 16+50.578
REVISED -Y7A- FROM ROUNDABOUT TO STA 11+19.323
REVISED -Y7D- FROM STA 11+37.944 TO ROUNDABOUT
R/W REVISED ROUNDABOUT CONFIGURATION 12-9-03

THIS SEAL APPLIES TO CONSTRUCTION REVISIONS NOTED ABOVE.

ROADWAY DESIGN ENGINEER

SEAL 13747
WARREN F. LAMB
11-26-03

HYDRAULICS ENGINEER

SEAL 16600
RANDALL C. HENEGAR
RC Henegar
12-3-03

KO & ASSOCIATES, P.C.
Consulting Engineers
1011 SCHAUB DR., SUITE #202
RALEIGH, N.C. 27606